


Plot Date: 20 October 2022 10:09:45
File Name: \\UKLDS2\FPFSW001 na.aecomnet.com\LE_PROJ\CTS\GIS Management\60606782 - Didcot Garden Town Schemes\GIS\02_Maps\Environmental Statement\CH13 Population and Health\DCGT_Prelim_97_PROW_Markup_20221020

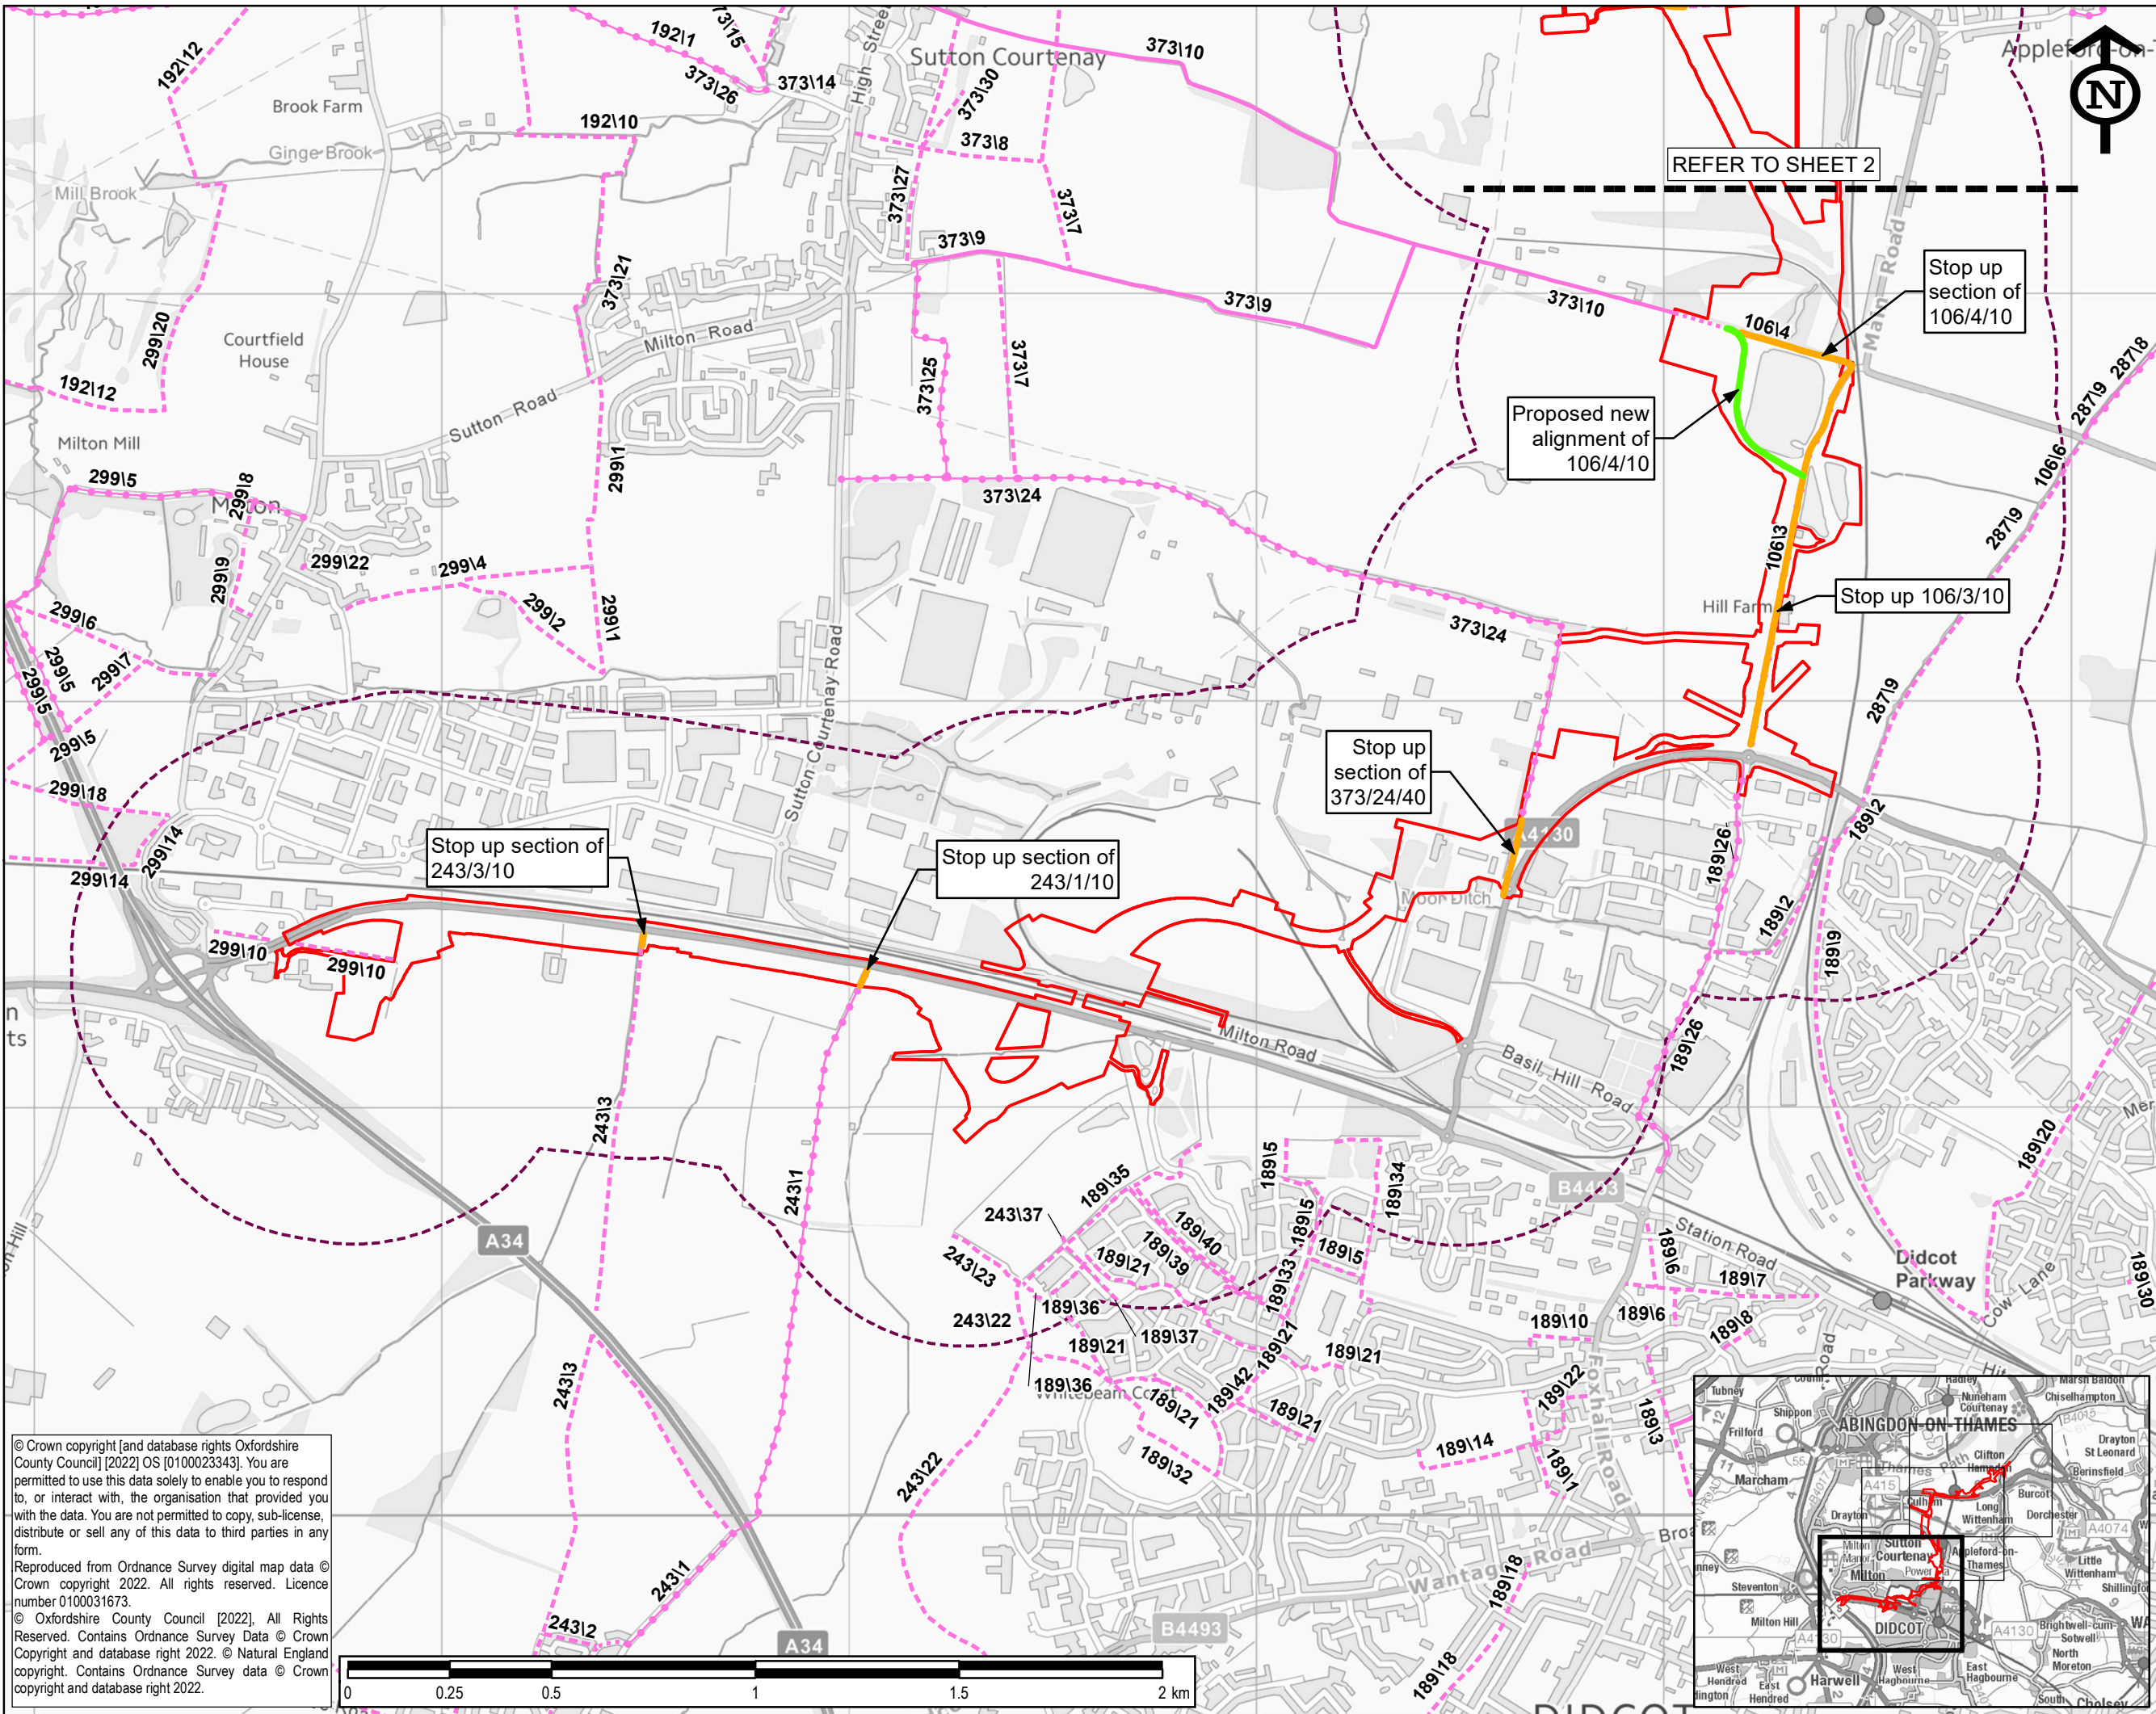

© Crown copyright [and database rights Oxfordshire County Council] [2022] OS [0100023343]. You are permitted to use this data solely to enable you to respond to, or interact with, the organisation that provided you with the data. You are not permitted to copy, sub-license, distribute or sell any of this data to third parties in any form.
Reproduced from Ordnance Survey digital map data © Crown copyright 2022. All rights reserved. Licence number 0100031673.
© Oxfordshire County Council [2022]. All Rights Reserved. Contains Ordnance Survey Data © Crown Copyright and database right 2022. © Natural England copyright. Contains Ordnance Survey data © Crown copyright and database right 2022.




LEGEND

- Indicative Red Line Boundary (Subject to Change)
- Indicative OCC Highway Design (Subject to Change)
- 500m Study Area
- National Trail
- Public Right of Way:
 - Byway Open to All
 - Public Bridleway
 - Public Footpath
 - Restricted Byway
- Public Right of Way Amendment:
 - Amended Alignment
 - New Alignment
 - Stop up

Contains public sector information licensed under the Open Government Licence v3.
<https://www.nationalarchives.gov.uk/doc/open-government-licence/version/3/>
The data provided is a working copy showing Public Rights of Way (PRoW) and is NOT the Definitive Map, so is not the legal record of PRoW and should not be treated as such. If there are any queries over the exact route or status of a PRoW you should get in touch with OCC Legal Services.

Second Issue	AG	20/10/22	P02
First Issue	AG	17/10/22	P01
Revision Details	By	Date	Suffix
Purpose of Issue	Check		
Client	OXFORDSHIRE COUNTY COUNCIL		
Project Title	DIDCOT GARDEN TOWN HIF 1 SCHEME		
Drawing Title	PROW AMENDMENTS SHEET 1 OF 3		
Designed SG	Drawn AG	Checked AGB	Approved KC
Internal Project No. 60606782	Suitability S1		
Scale @ A3 1:15,000	Discipline General		
THIS DOCUMENT HAS BEEN PREPARED PURSUANT TO AND SUBJECT TO THE TERMS OF AECOM'S APPOINTMENT BY ITS CLIENT. AECOM ACCEPTS NO LIABILITY FOR ANY USE OF THIS DOCUMENT OTHER THAN BY ITS ORIGINAL CLIENT OR FOLLOWING AECOM'S EXPRESS AGREEMENT TO SUCH USE, AND ONLY FOR THE PURPOSES FOR WHICH IT WAS PREPARED AND PROVIDED.			
AECOM 5th Floor 2 Citywalk Leeds, LS11 9AR Telephone (0113) 391 6800 www.aecom.com		AECOM AECOM Infrastructure & Environment UK Limited Registered in England Registered number: 880328 Registered office: Scott House, Aconit Link, Basingstoke, Hampshire RG21 7PP	
Drawing Number GEN_PD-ACM-EGN-DGT_ZZ_ZZ-FG-EG-0005	Volume	Type	Number
Originator	Location	Role	Rev
			P02

Plot Date: 20 October 2022 10:09:45
File Name: \\UKLD52\FPS\W001 na.aecomnet.com\LE_PRO\ECTS\GIS Management\60606782 - Didcot Garden Town Schemes\GIS\02_Maps\Environmental Statement\CH13 Population and Health\DGT_Prelim_97_PRoW_Markup_20221020

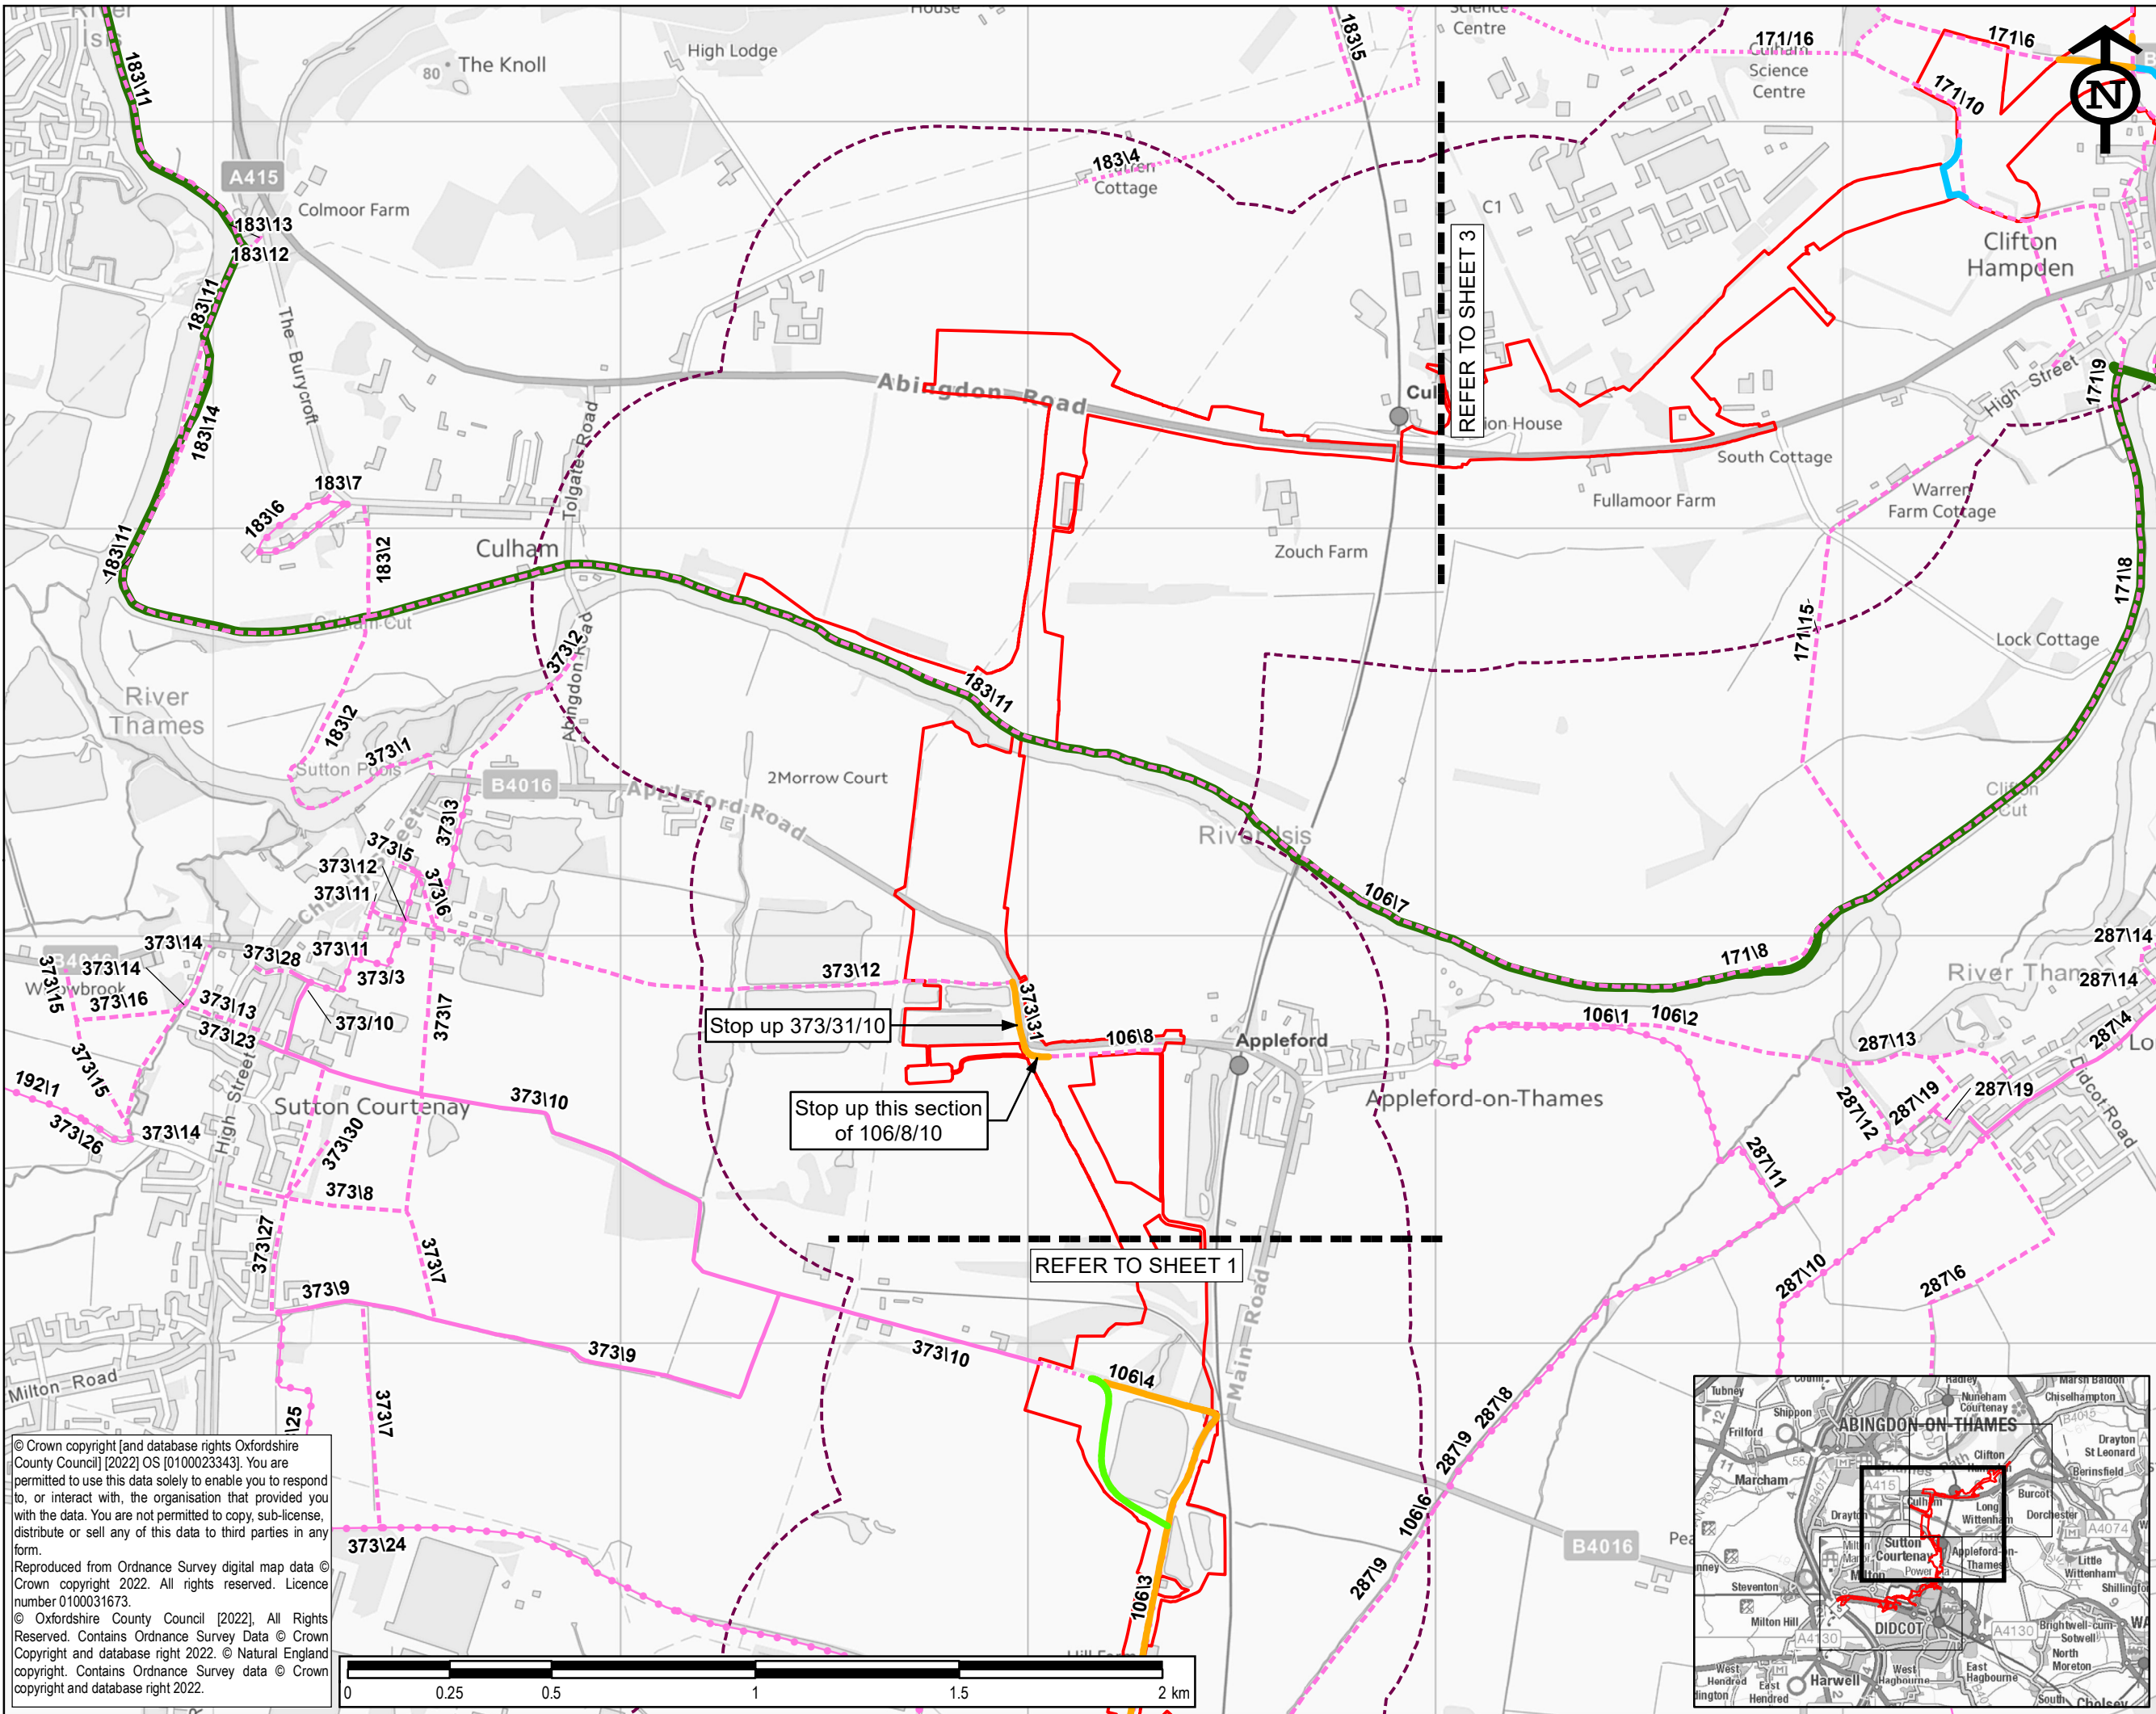


© Crown copyright [and database rights Oxfordshire County Council] [2022] OS [0100023343]. You are permitted to use this data solely to enable you to respond to, or interact with, the organisation that provided you with the data. You are not permitted to copy, sub-license, distribute or sell any of this data to third parties in any form.
Reproduced from Ordnance Survey digital map data © Crown copyright 2022. All rights reserved. Licence number 0100031673.
© Oxfordshire County Council [2022]. All Rights Reserved. Contains Ordnance Survey Data © Crown Copyright and database right 2022. © Natural England copyright. Contains Ordnance Survey data © Crown copyright and database right 2022.

LEGEND

- Indicative Red Line Boundary (Subject to Change)
- Indicative OCC Highway Design (Subject to Change)
- 500m Study Area
- National Trail
- Public Right of Way:
 - Byway Open to All
 - Public Bridleway
 - Public Footpath
 - Restricted Byway
- Public Right of Way Amendment:
 - Amended Alignment
 - New Alignment
 - Stop up

Contains public sector information licensed under the Open Government Licence v3. <https://www.nationalarchives.gov.uk/doc/open-government-licence/version/3/>
The data provided is a working copy showing Public Rights of Way (PRoW) and is NOT the Definitive Map, so is not the legal record of PRoW and should not be treated as such. If there are any queries over the exact route or status of a PRoW you should get in touch with OCC Legal Services.

Second Issue	AG	20/10/22	P02
First Issue	AG	17/10/22	P01
Revision Details	By	Date	Suffix
Purpose of issue	Check		
Client	OXFORDSHIRE COUNTY COUNCIL		
Project Title	DIDCOT GARDEN TOWN HIF 1 SCHEME		
Drawing Title	PROW AMENDMENTS SHEET 2 OF 3		
Designed SG	Drawn AG	Checked AGB	Approved KC
Internal Project No. 60606782	S1		
Scale @ A3 1:15,000	Discipline General		
THIS DOCUMENT HAS BEEN PREPARED PURSUANT TO AND SUBJECT TO THE TERMS OF AECOM'S APPOINTMENT BY ITS CLIENT. AECOM ACCEPTS NO LIABILITY FOR ANY USE OF THIS DOCUMENT OTHER THAN BY ITS ORIGINAL CLIENT OR FOLLOWING AECOM'S EXPRESS AGREEMENT TO SUCH USE, AND ONLY FOR THE PURPOSES FOR WHICH IT WAS PREPARED AND PROVIDED.			
AECOM 5th Floor 2 Citywalk Leeds, LS11 9AR Telephone (0113) 391 6800 www.aecom.com		AECOM AECOM Infrastructure & Environment UK Limited Registered in England Registered number: 860328 Registered office: Scott House, Aecom Link, Basingstoke, Hampshire RG21 7PP	
Drawing Number GEN_PD-ACM-EGN-DGT_ZZ_ZZ-FG-EG-0005	Volume	Type	Number
Originator	Location	Role	Rev
			P02

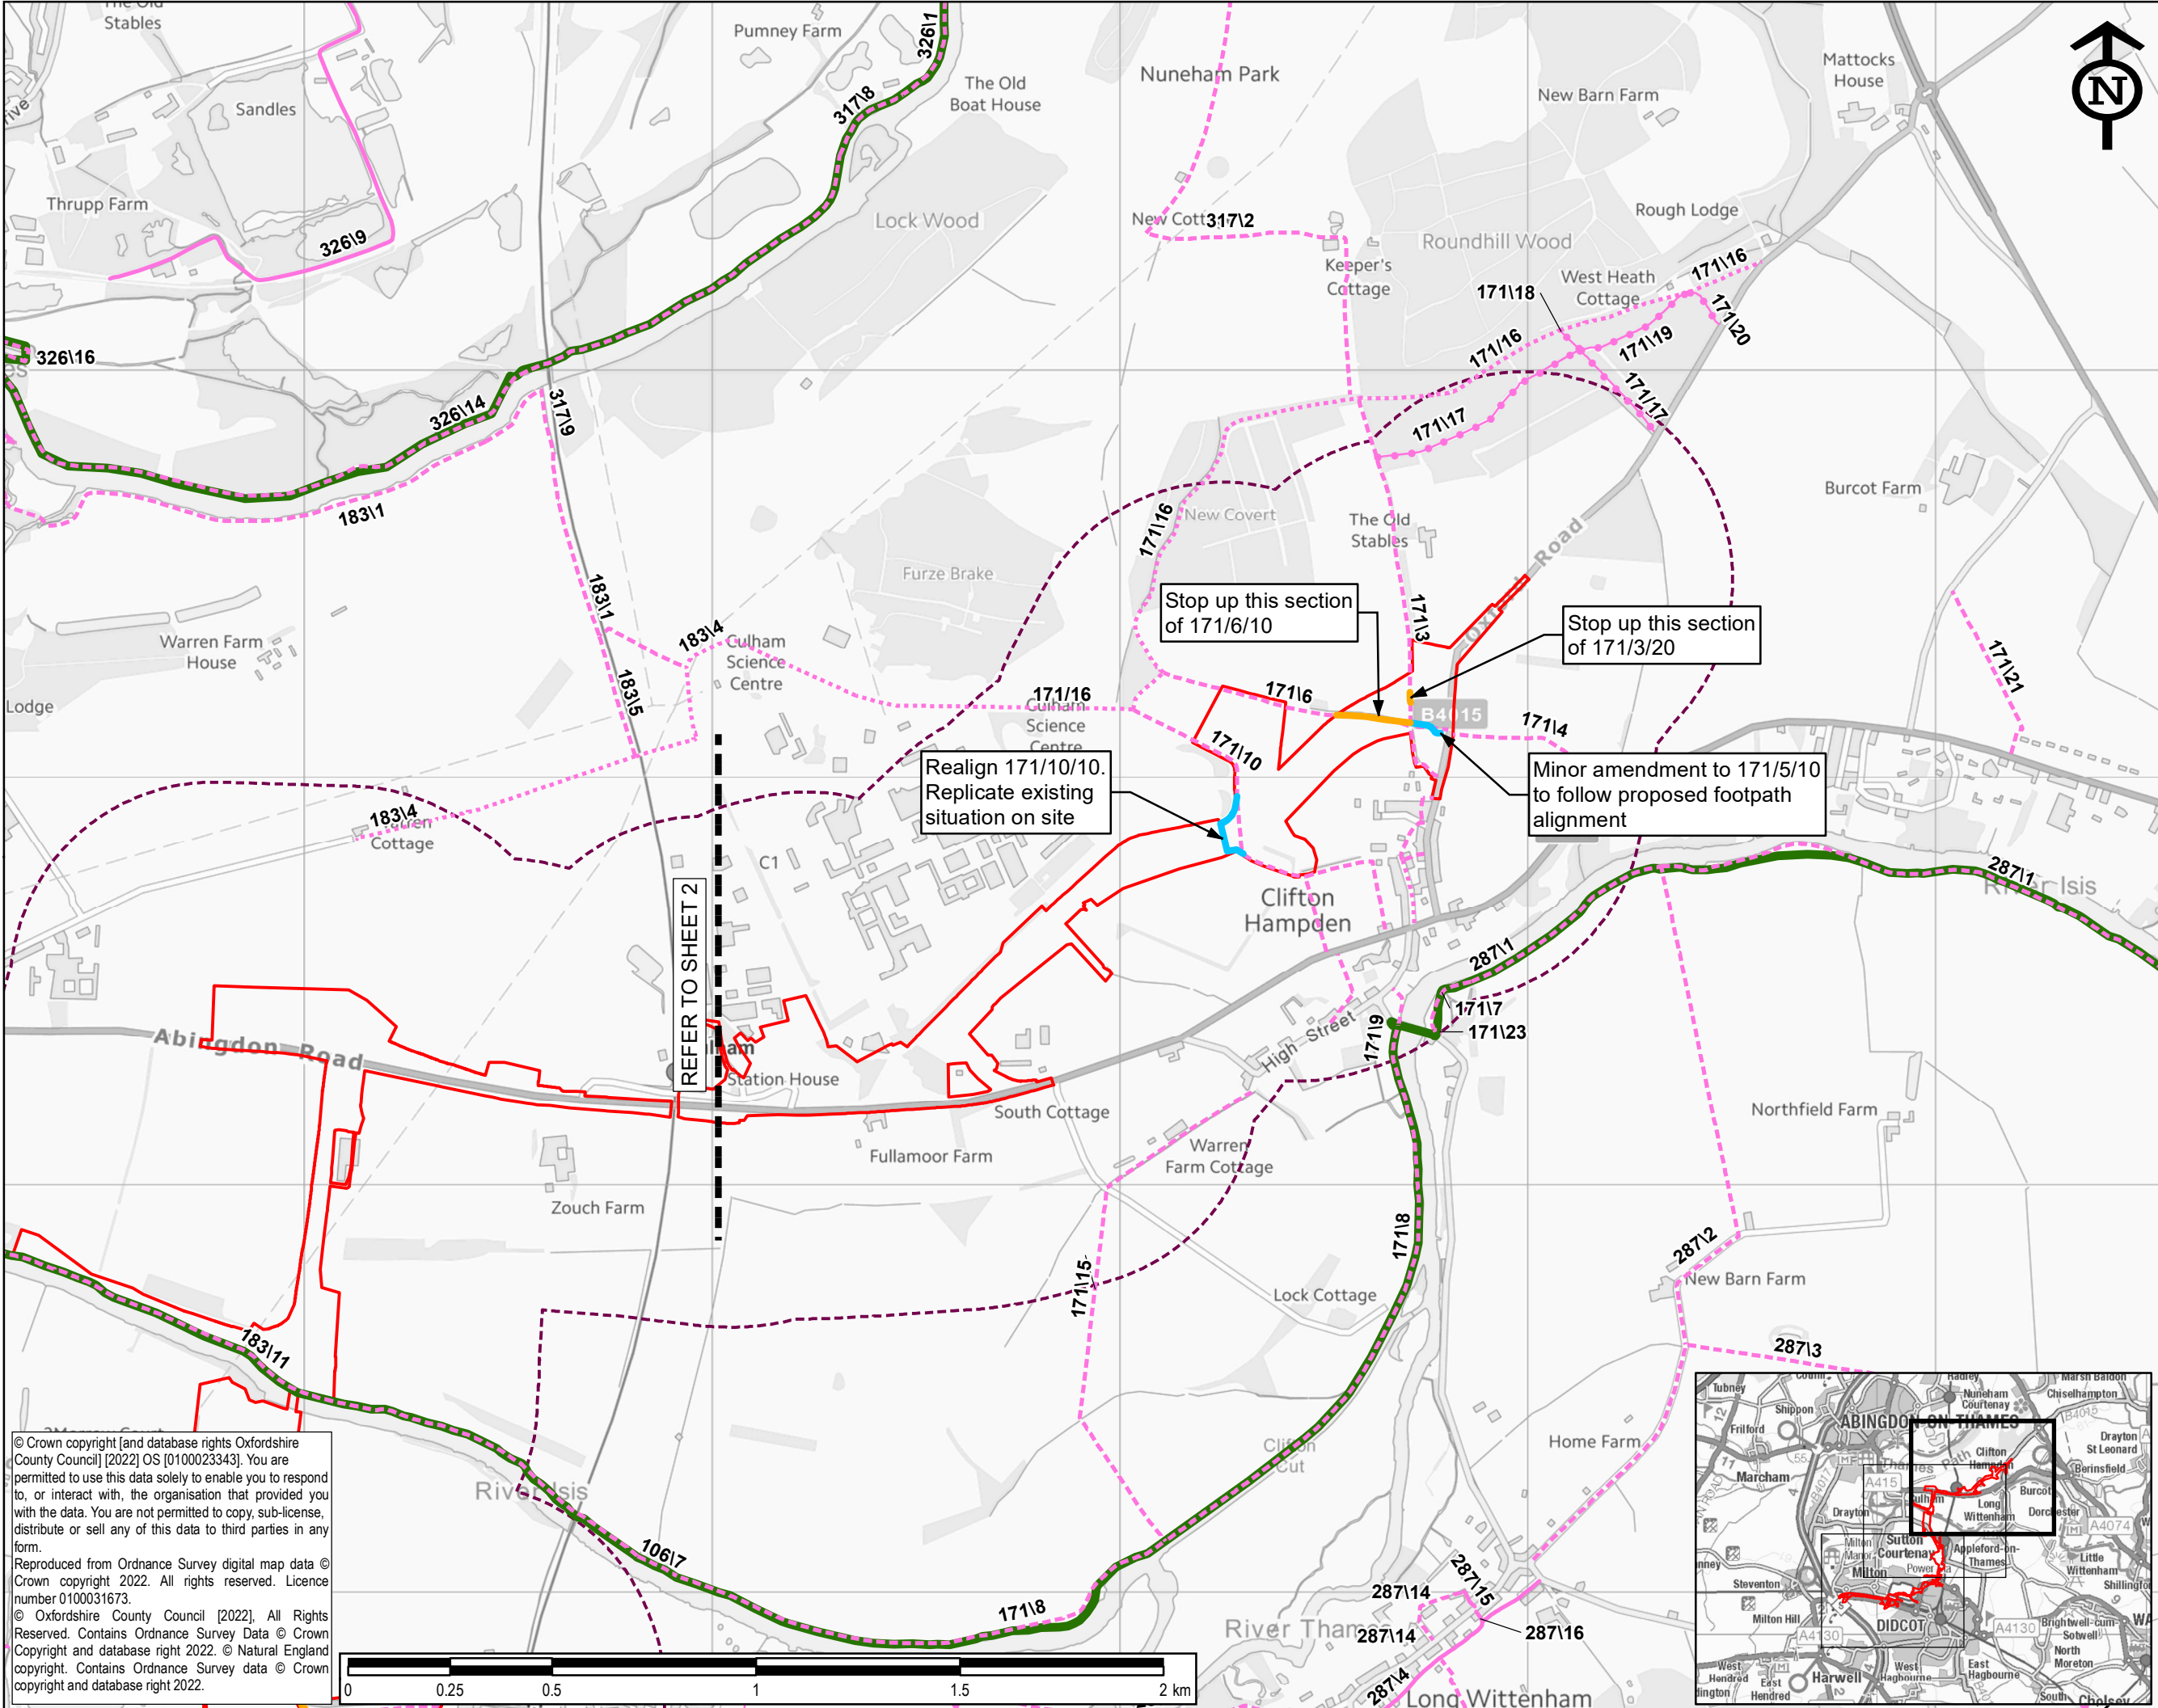

LEGEND

- Indicative Red Line Boundary (Subject to Change)
- Indicative OCC Highway Design (Subject to Change)
- 500m Study Area
- National Trail
- Public Right of Way:
 - Byway Open to All
 - Public Bridleway
 - Public Footpath
 - Restricted Byway
- Public Right of Way Amendment:
 - Amended Alignment
 - New Alignment
 - Stop up

Contains public sector information licensed under the Open Government Licence v3. <https://www.nationalarchives.gov.uk/doc/open-government-licence/version/3/>
The data provided is a working copy showing Public Rights of Way (PRoW) and is NOT the Definitive Map, so is not the legal record of PRoW and should not be treated as such. If there are any queries over the exact route or status of a PRoW you should get in touch with OCC Legal Services.

Second Issue	AG	20/10/22	P02	
First Issue	AG	17/10/22	P01	
Revision Details	By	Check	Date	Suffix
Purpose of Issue	FOR INFORMATION			
Client	OXFORDSHIRE COUNTY COUNCIL			
Project Title	DIDCOT GARDEN TOWN HIF 1 SCHEME			
Drawing Title	PROW AMENDMENTS SHEET 3 OF 3			
Designed SG	Drawn AG	Checked AGB	Approved KC	Date 20/10/2022
Internal Project No. 60606782	Suitability S1			
Scale @ A3 1:15,000	Discipline General			
THIS DOCUMENT HAS BEEN PREPARED PURSUANT TO AND SUBJECT TO THE TERMS OF AECOM'S APPOINTMENT BY ITS CLIENT. AECOM ACCEPTS NO LIABILITY FOR ANY USE OF THIS DOCUMENT OTHER THAN BY ITS ORIGINAL CLIENT OR FOLLOWING AECOM'S EXPRESS AGREEMENT TO SUCH USE, AND ONLY FOR THE PURPOSES FOR WHICH IT WAS PREPARED AND PROVIDED.				
AECOM 5th Floor 2 Citywalk Leeds, LS11 9AR Telephone (0113) 391 6800 www.aecom.com		AECOM AECOM Infrastructure & Environment UK Limited Registered in England Registered number: 860328 Registered office: Scott House, Alenon Link, Basingstoke, Hampshire RG21 7PP		
Drawing Number GEN_PD-ACM-EGN-DGT_ZZ_ZZ-FG-EG-0005	Volume	Type	Number	Rev
Originator	Location	Role		P02

Plot Date: 20 October 2022 10:09:45
File Name: \\UKLDS2\FPSW001\LE_PROJ\EGN\GIS Management\60606782 - Didcot Garden Town Schemes\GIS\02_Maps\Environmental Statement\CH13 Population and Health\DTG_Prelim_97_ProW_Markup_20221020

© Crown copyright [and database rights Oxfordshire County Council] [2022] OS [0100023343]. You are permitted to use this data solely to enable you to respond to, or interact with, the organisation that provided you with the data. You are not permitted to copy, sub-license, distribute or sell any of this data to third parties in any form.
Reproduced from Ordnance Survey digital map data © Crown copyright 2022. All rights reserved. Licence number 0100031673.
© Oxfordshire County Council [2022]. All Rights Reserved. Contains Ordnance Survey Data © Crown Copyright and database right 2022. © Natural England copyright. Contains Ordnance Survey data © Crown copyright and database right 2022.