


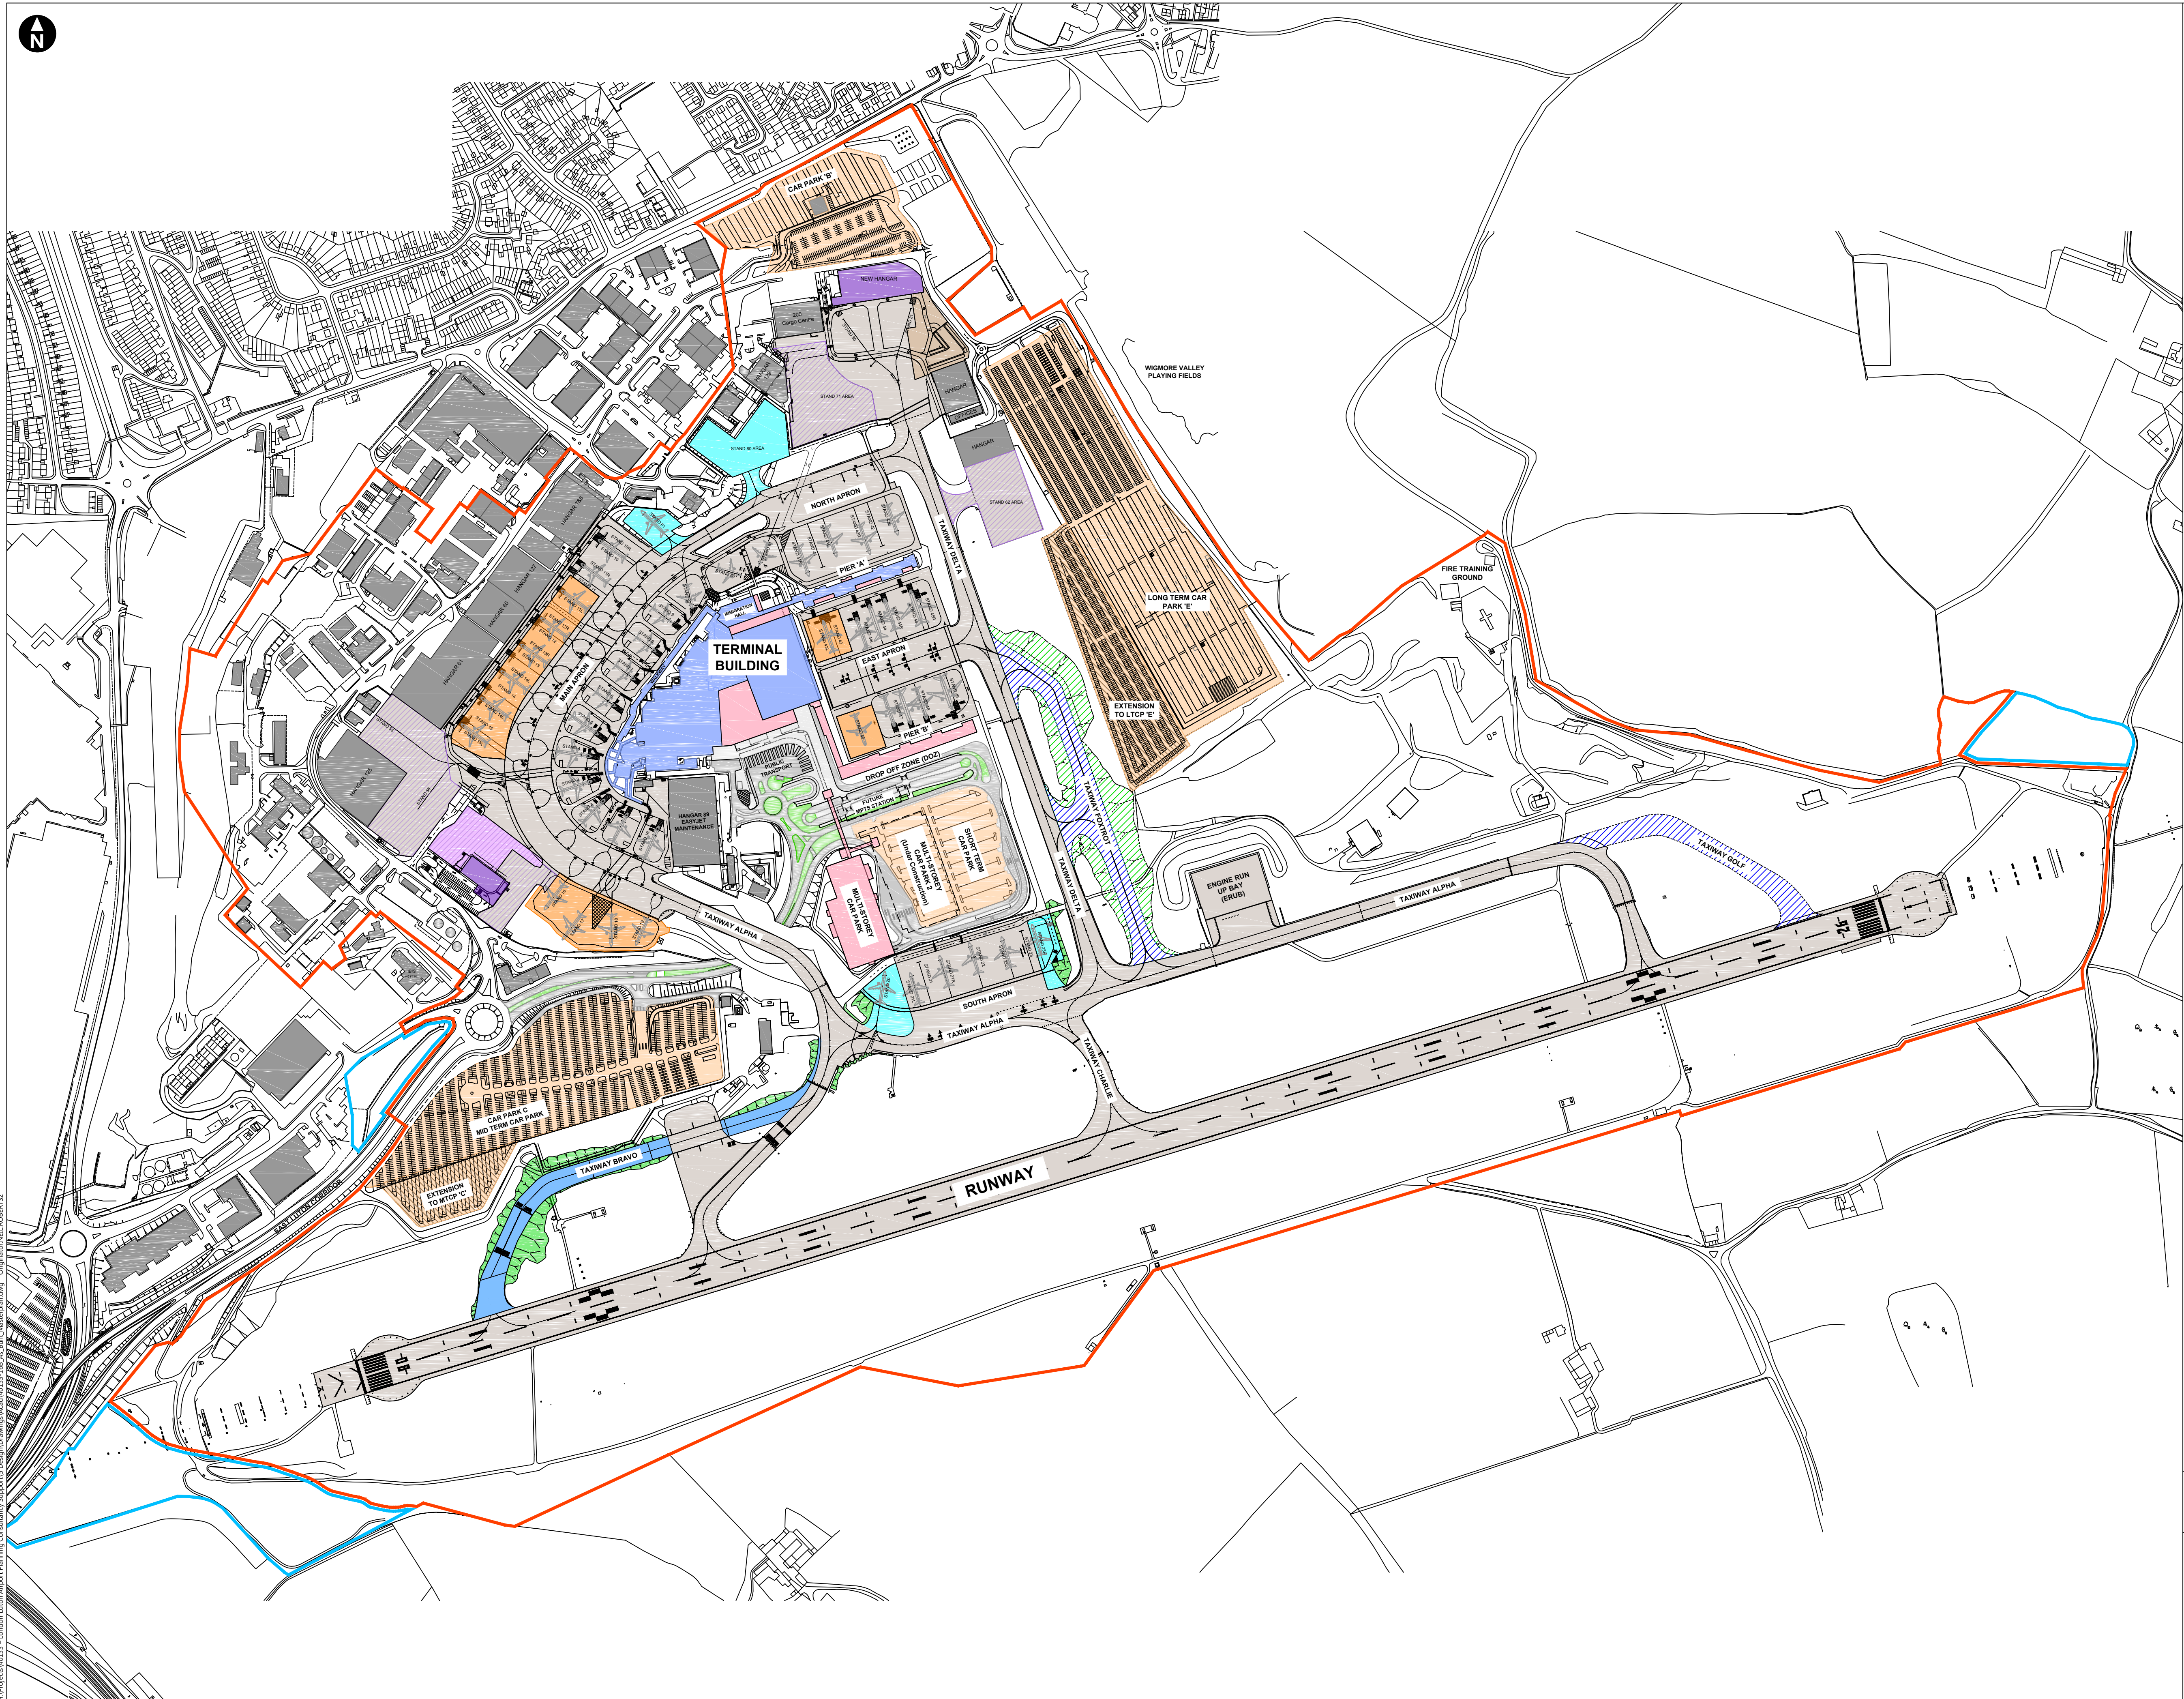

Note: This drawing is for information only.

This drawing has been compiled by Wood using original drawings and PDFs from multiple contractors. Drawings have been converted to CAD using available software. The small scale accuracy of the drawings incorporated herein is not guaranteed. Contractors are responsible for the verification of all dimensions on site and are to inform the client of any discrepancy. Do not scale from this drawing.

Key

- Existing terminal buildings
- New terminal buildings
- Remarking of existing aircraft stands
- New aircraft stands
- Taxiway extensions
- Future taxiway extensions
- CTA road layout
- Existing car park
- Car park extension
- Regrading and grassing of existing hard standing areas
- FBO buildings, hangar & apron
- Mixed commercial/FBO apron use
- Relocated cargo compound
- Indicates extent of site boundary
- Indicates other lands owned and or under the control of the applicant

0 m 200 m
Scale 1:4000 @ A1

© Crown copyright. All rights reserved. Licence number AL100001776.

Client

London Luton Airport

London Luton Airport

As-Built Master Plan

March 2019

wood.